City Hall Building A

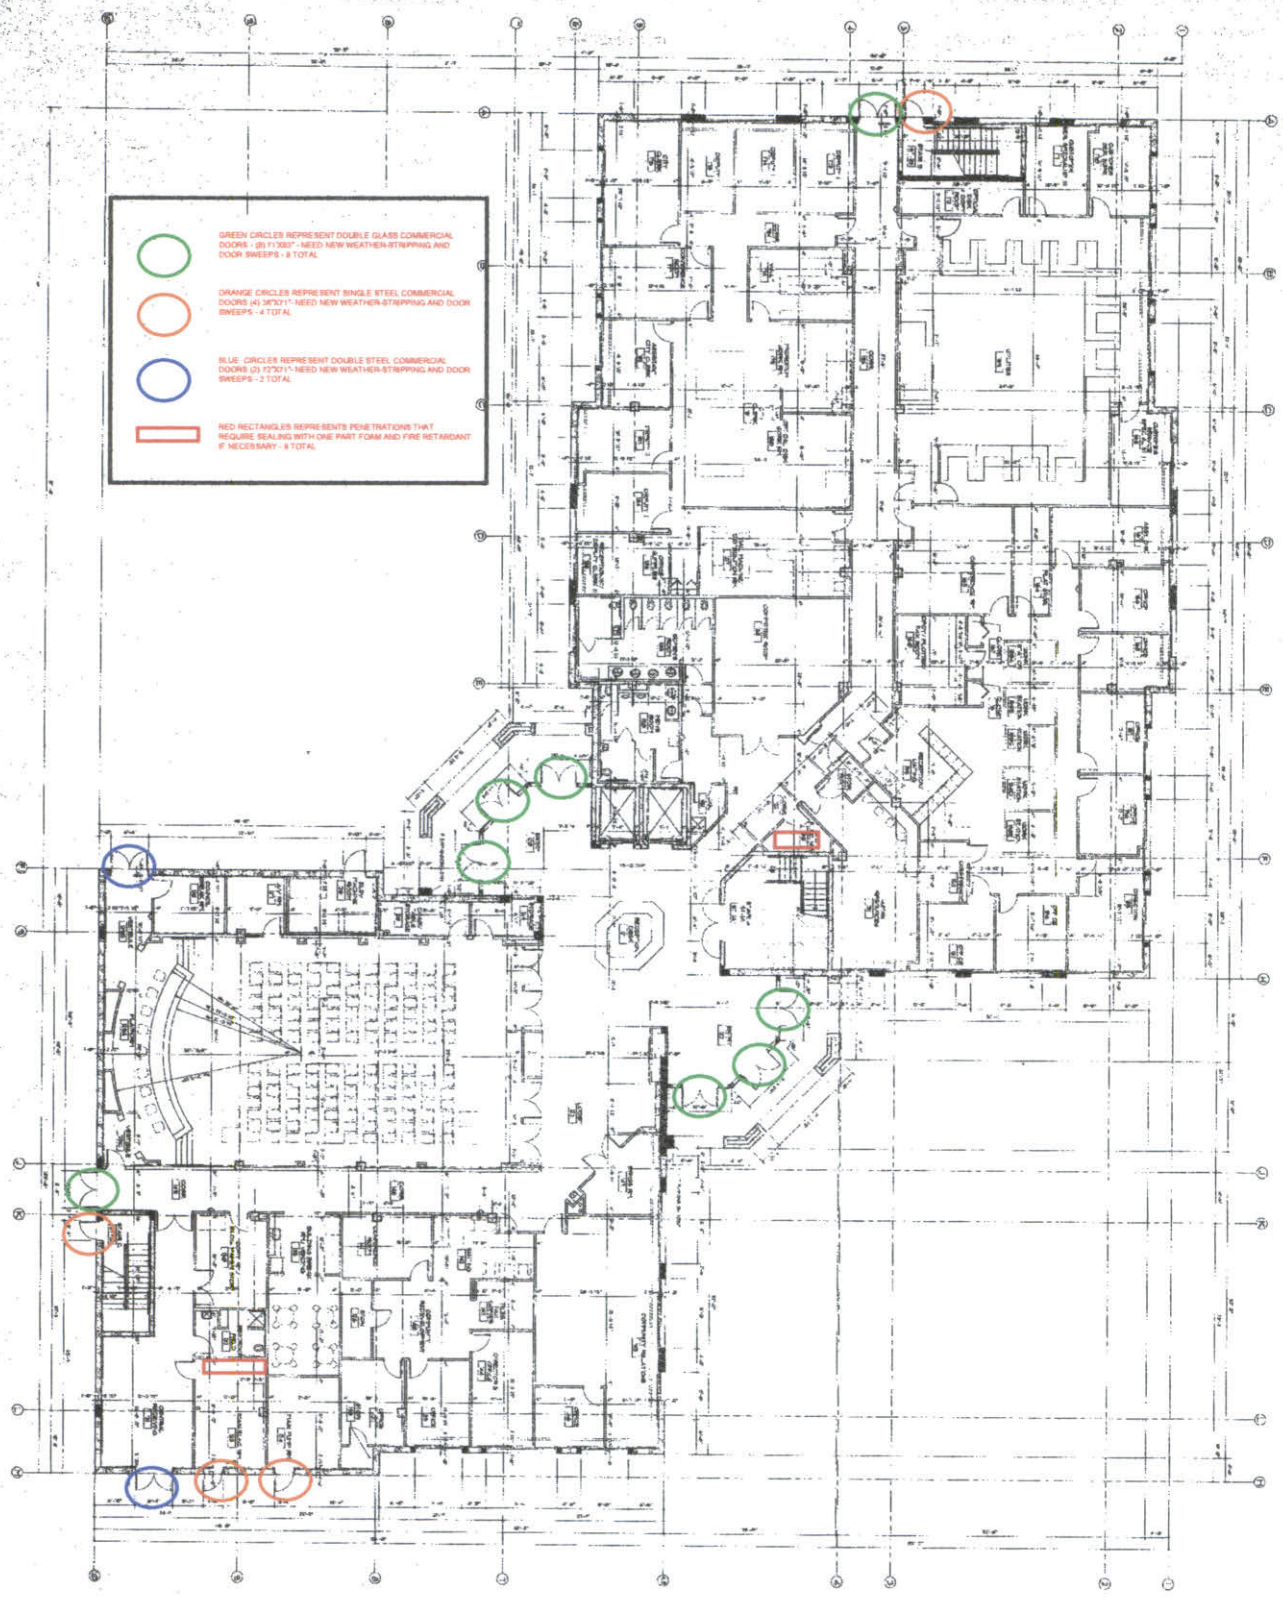

First Floor Dimension Plan

Scale: 1/8" = 1'-0"

A3.1.2

Port St. Lucie City Hall

Port St. Lucie, Florida

Schwab, Twitty & Hanser
Architectural Group, Inc.
Northridge Centre, Suite 1400
515 North Flagler Drive
West Palm Beach, Florida 33401
(561) 832-0566
(561) 655-4629 fax

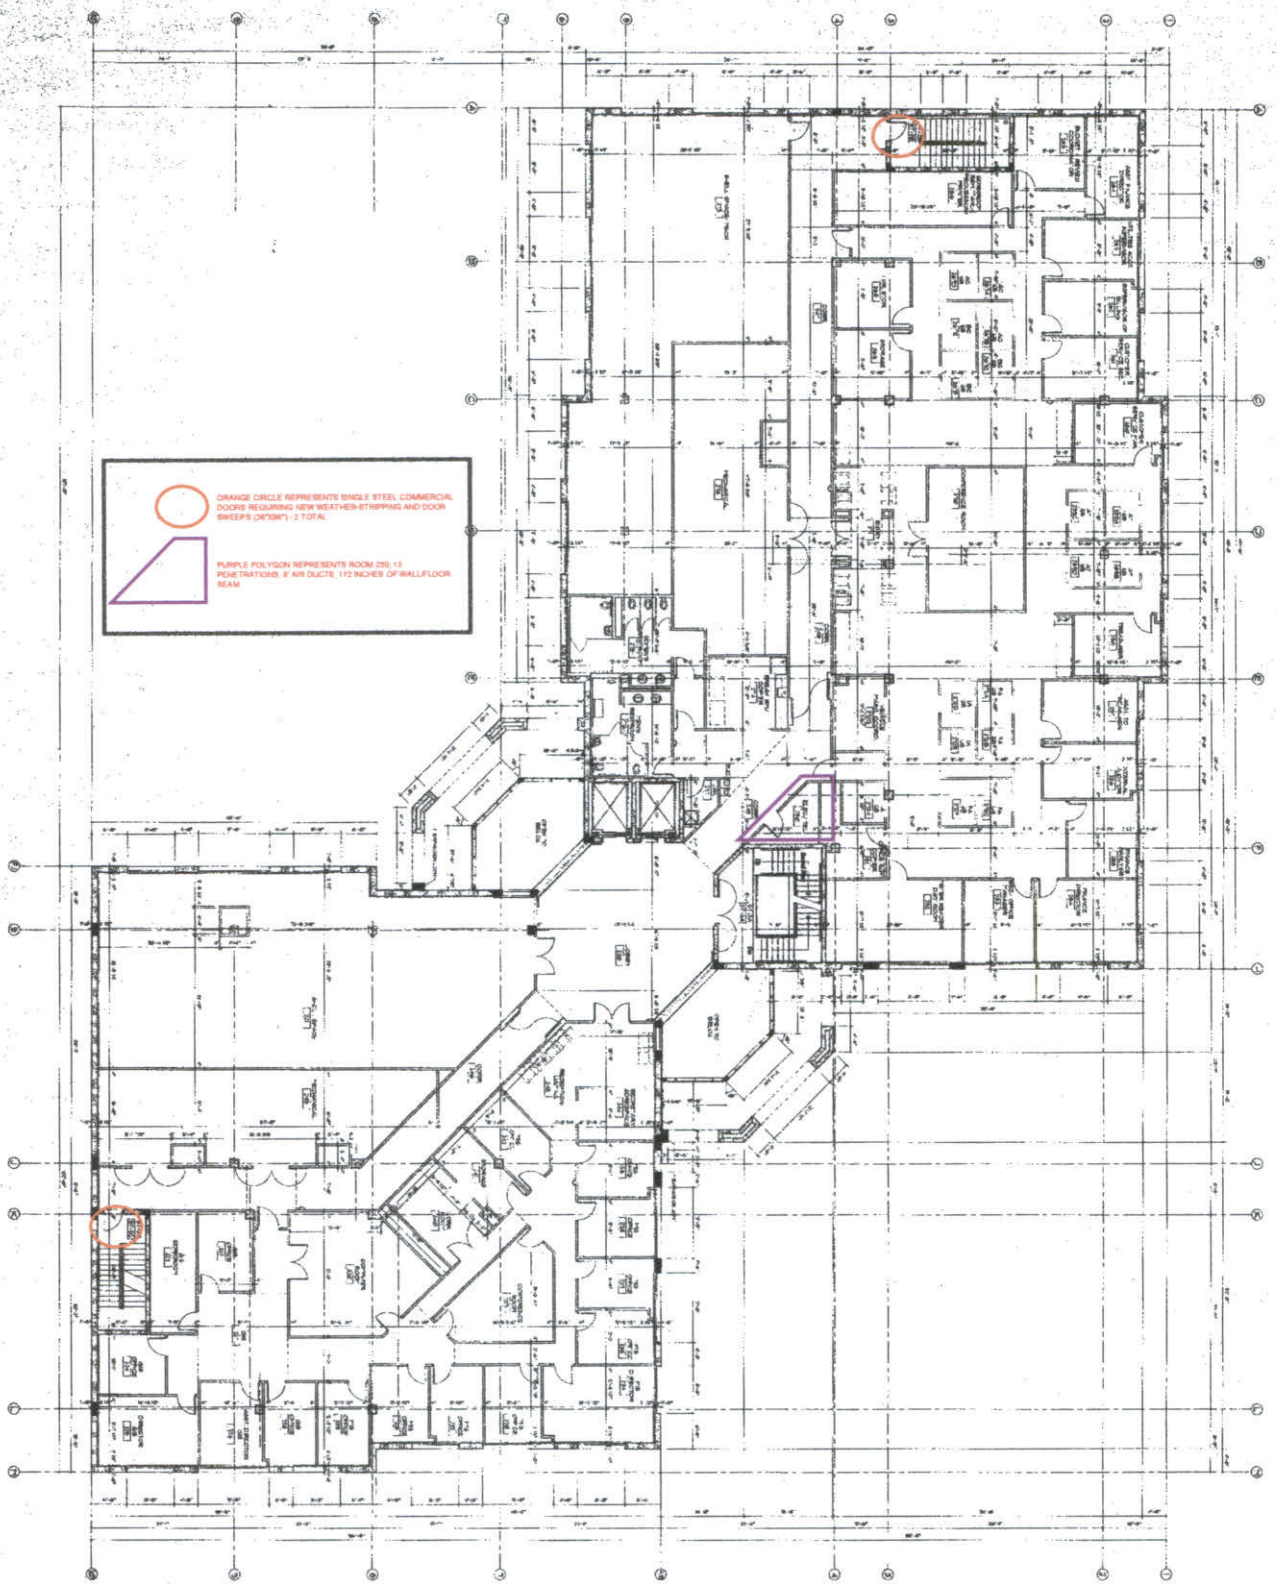

Second Floor Dimension Plan ***Scale: 1/8" = 1'-0"***

A3.2.2

Port St. Lucie City Hall

Port St. Lucie, Florida

Schwab, Twitty & Hanser
Architectural Group, Inc
Northbridge Centre, Suite 1400
515 North Flagler Drive
West Palm Beach, Florida 33401
(561) 832-5599
(561) 832-4888 fax

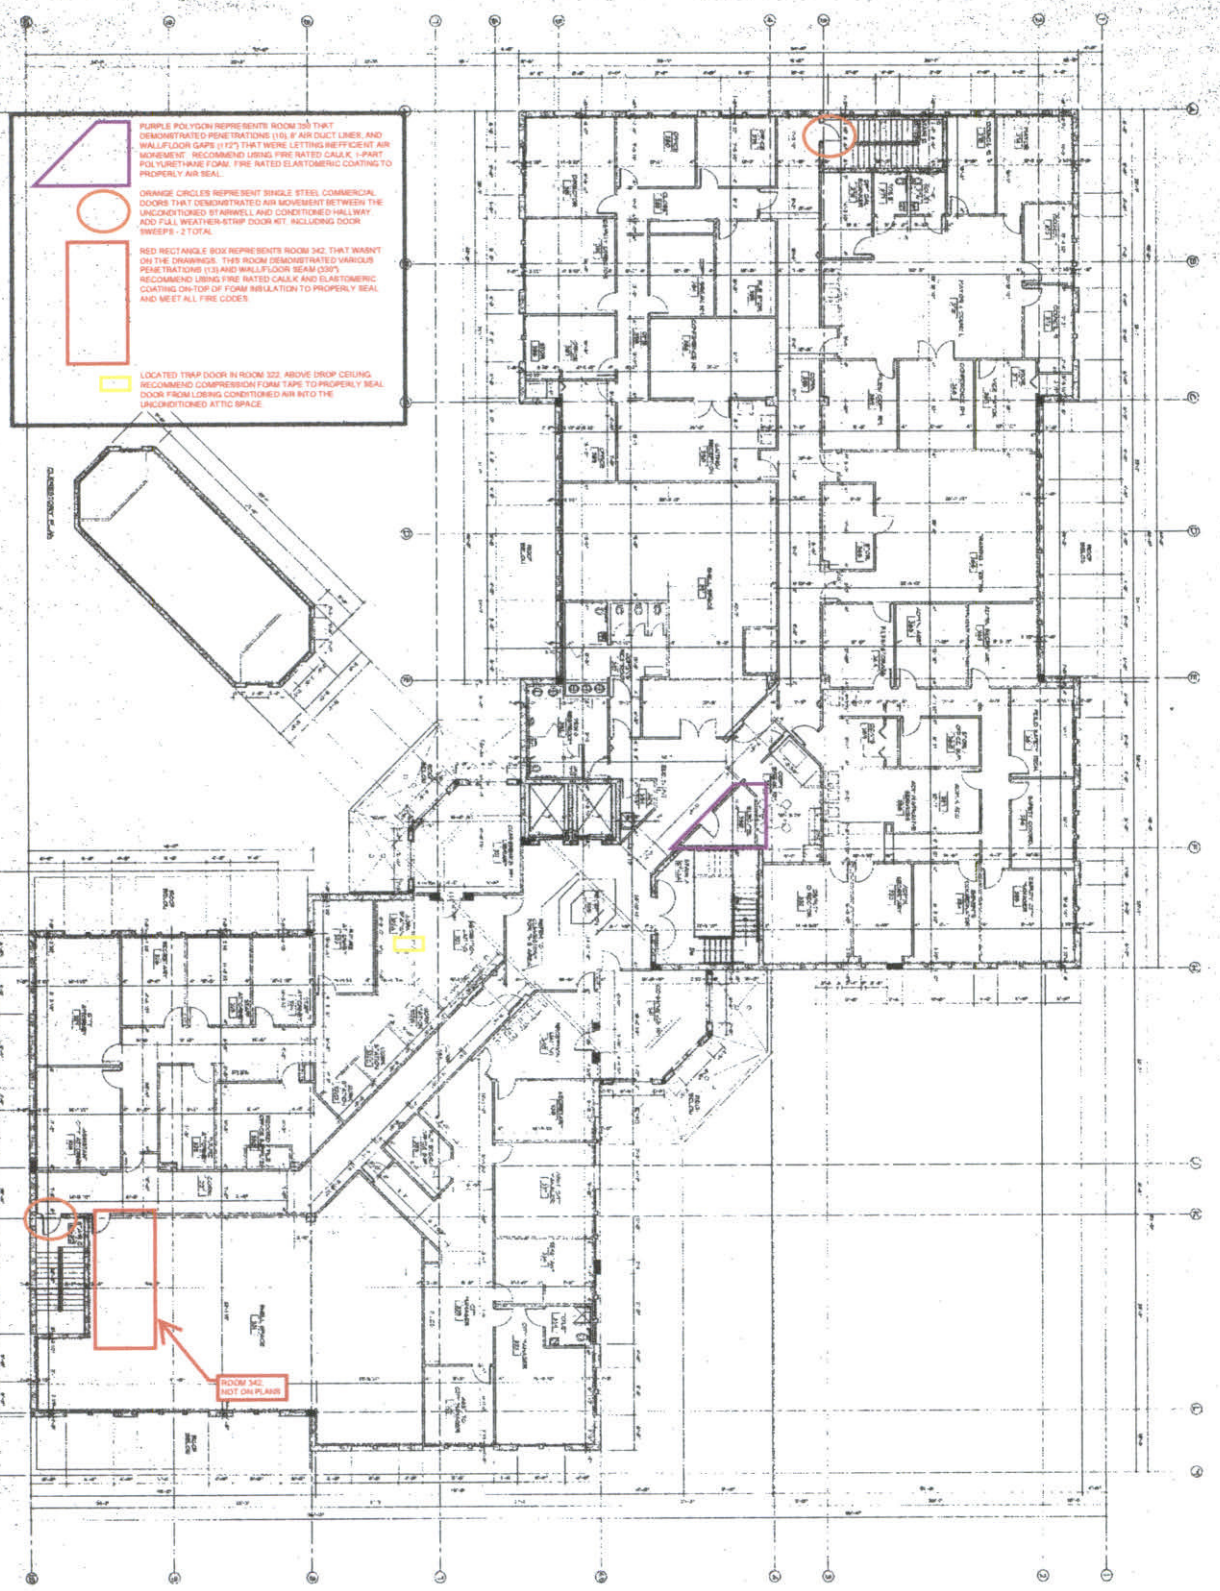

Third Floor Dimension Plan ***Scale: 1/8" = 1'-0"***

A3.3.2

Port St. Lucie City Hall

Port St. Lucie, Florida

Schwab, Twitty & Hanser Architectural Group, Inc.
Northbridge Centre, Suite 1400
515 North Flagler Drive
West Palm Beach, Florida 33401
(561) 802-9099
(561) 655-4028 fax

City Hall Building B

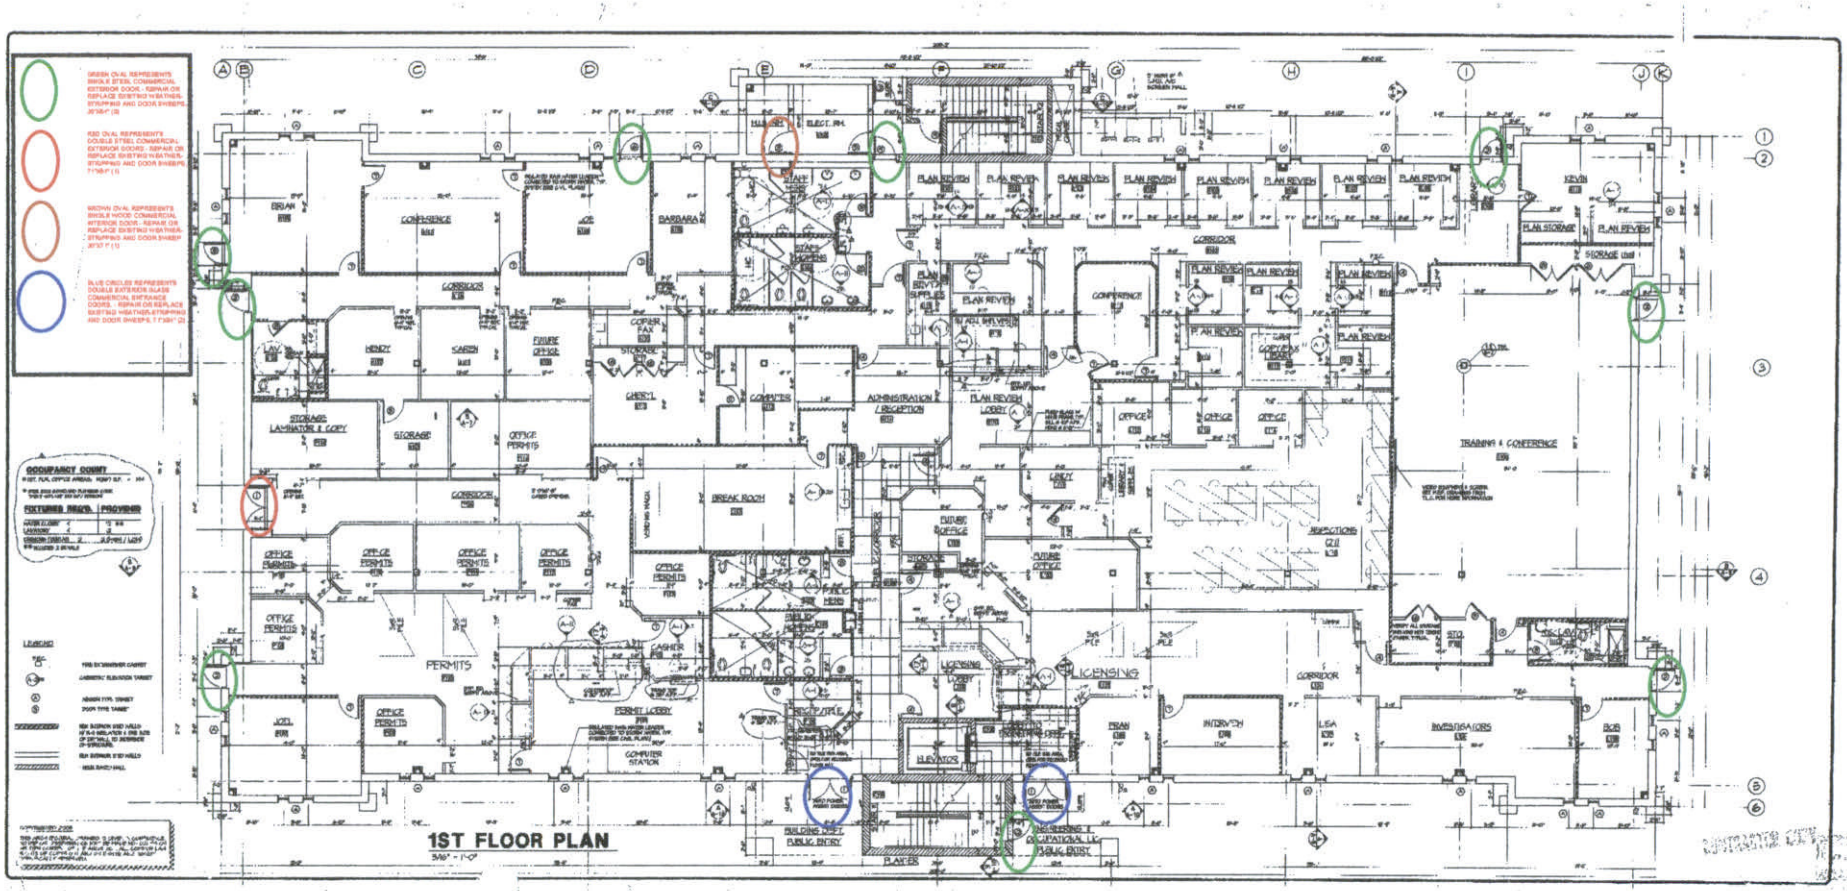
1ST FLOOR PLAN
3/16" = 1'-0"
NEW BUILDING FOR:
THE CITY OF PORT SAINT LUCIE
BUILDING "D"
PORT SAINT LUCIE, FLORIDA
A-1
PERMITS
LICENSING
TRAINING & CONFERENCE
BREAK ROOM
ADMINISTRATION / RECEPTION
INSPECTORS
PLAN REVIEW
OFFICE PERMITS
CORRIDOR
STORAGE
OCCUPANCY COUNT
FIXTURES REQ'D.
PROVIDED

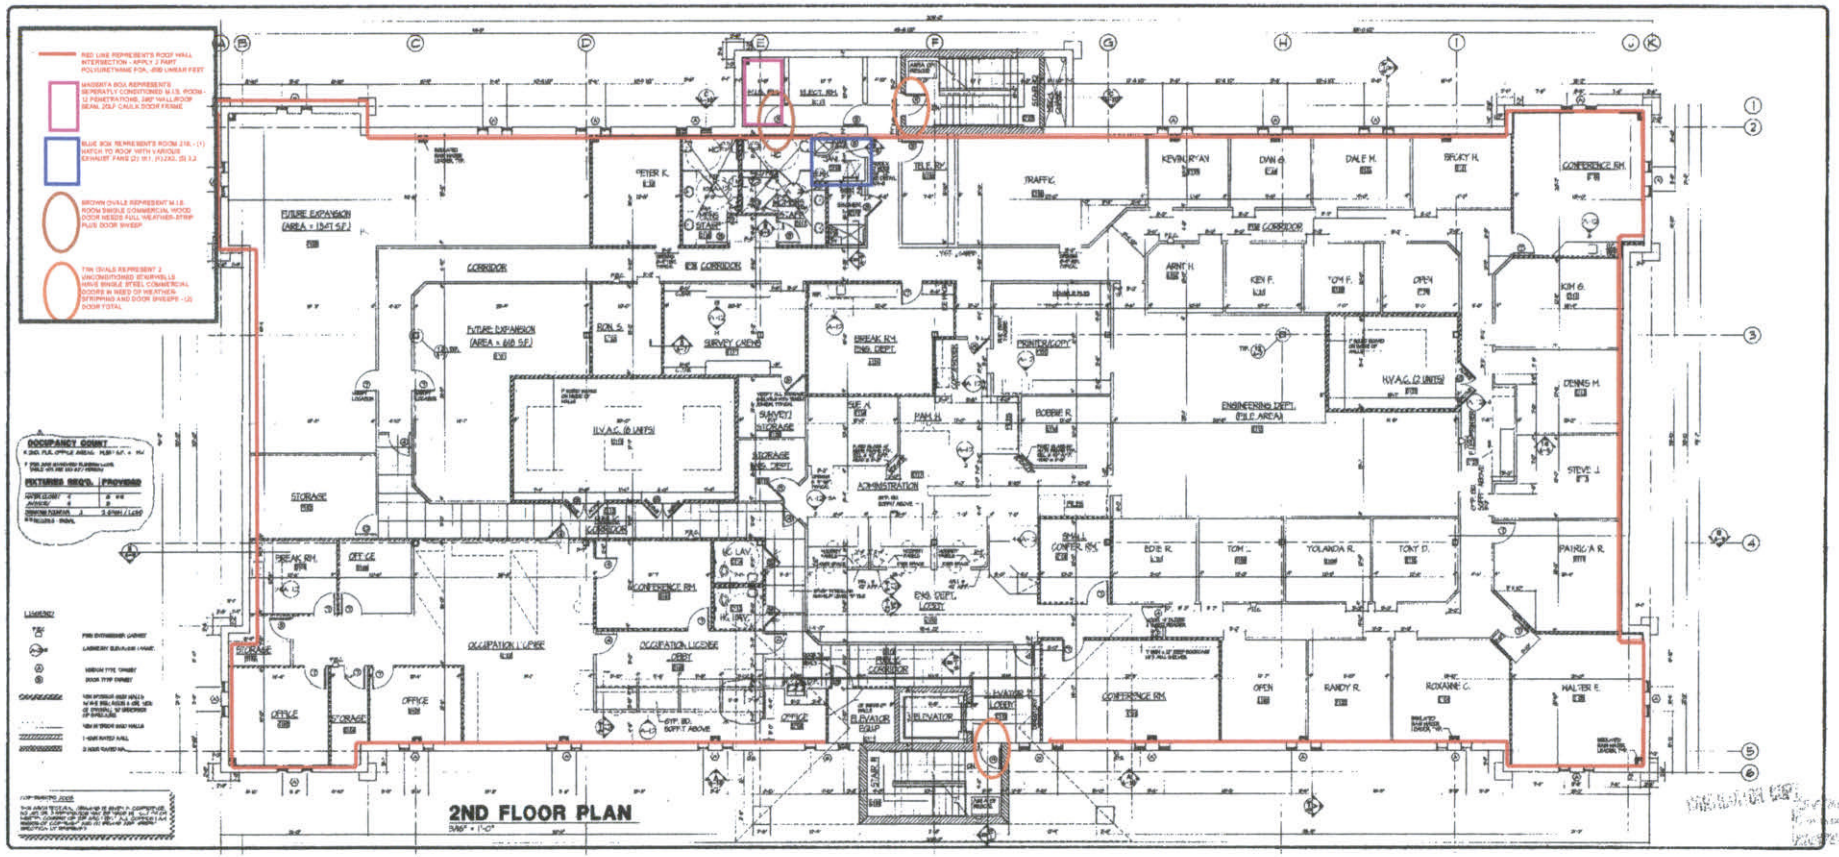
2ND FLOOR PLAN
NEW BUILDING FOR:
THE CITY OF PORT SAINT LUCIE
BUILDING "D"
PORT SAINT LUCIE, FLORIDA
A-2

Community Center

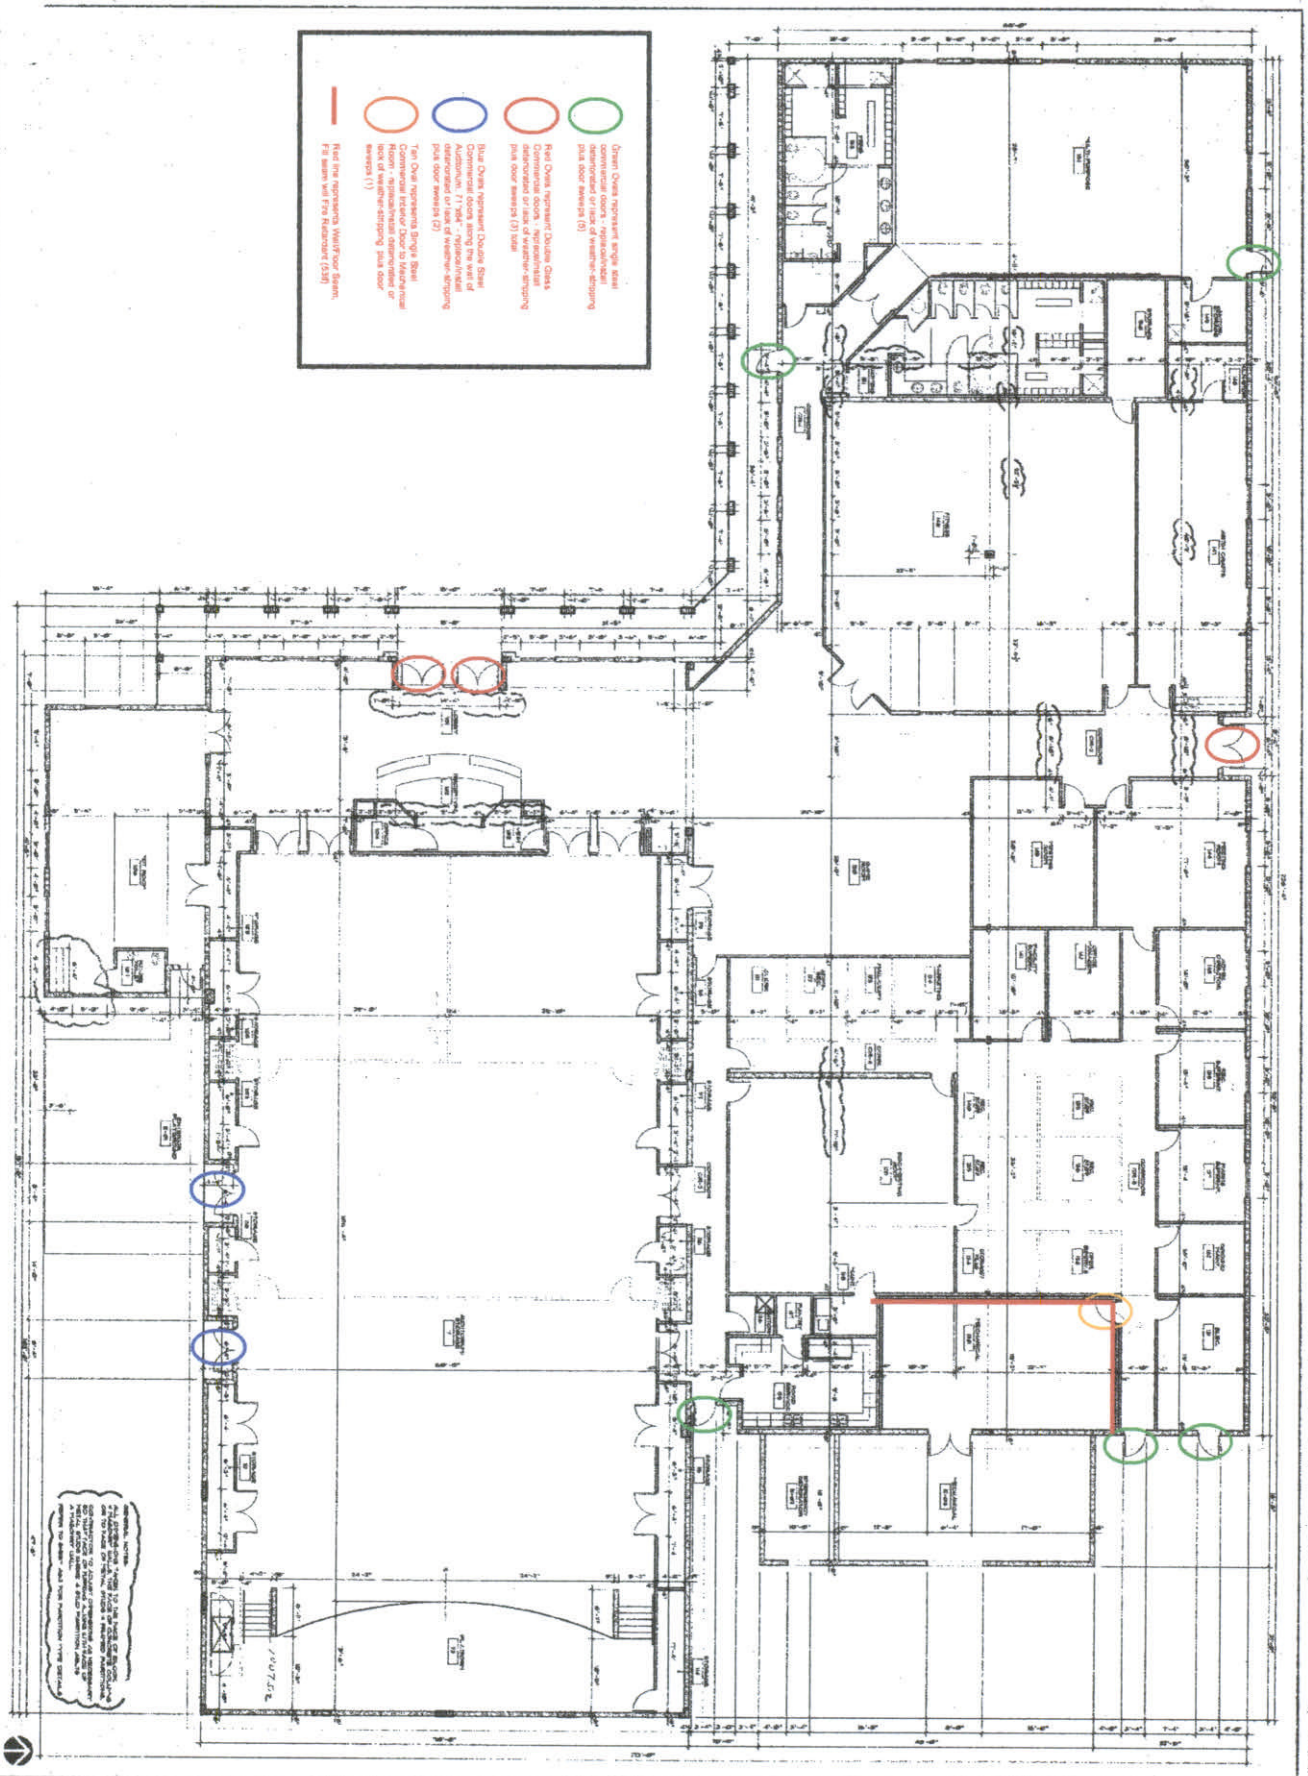

Dimension Plan — **Scale: 1/8"= 1'-0"**

A2.2			**AIROSO COMMUNITY CENTER** **PORT ST. LUCIE, FLORIDA**

Schwab, Twitty & Hanser
Architectural Group, Inc.
Northbridge Centre, Suite 400
515 North Flagler Drive
West Palm Beach, Florida 33401
(561) 655-8336
(561) 655-4326 fax
Email: Caldi • STH-ARCH.com

COPYRIGHT © 1997 STH ARCHITECTS, INC. ALL RIGHTS RESERVED

Civic Center

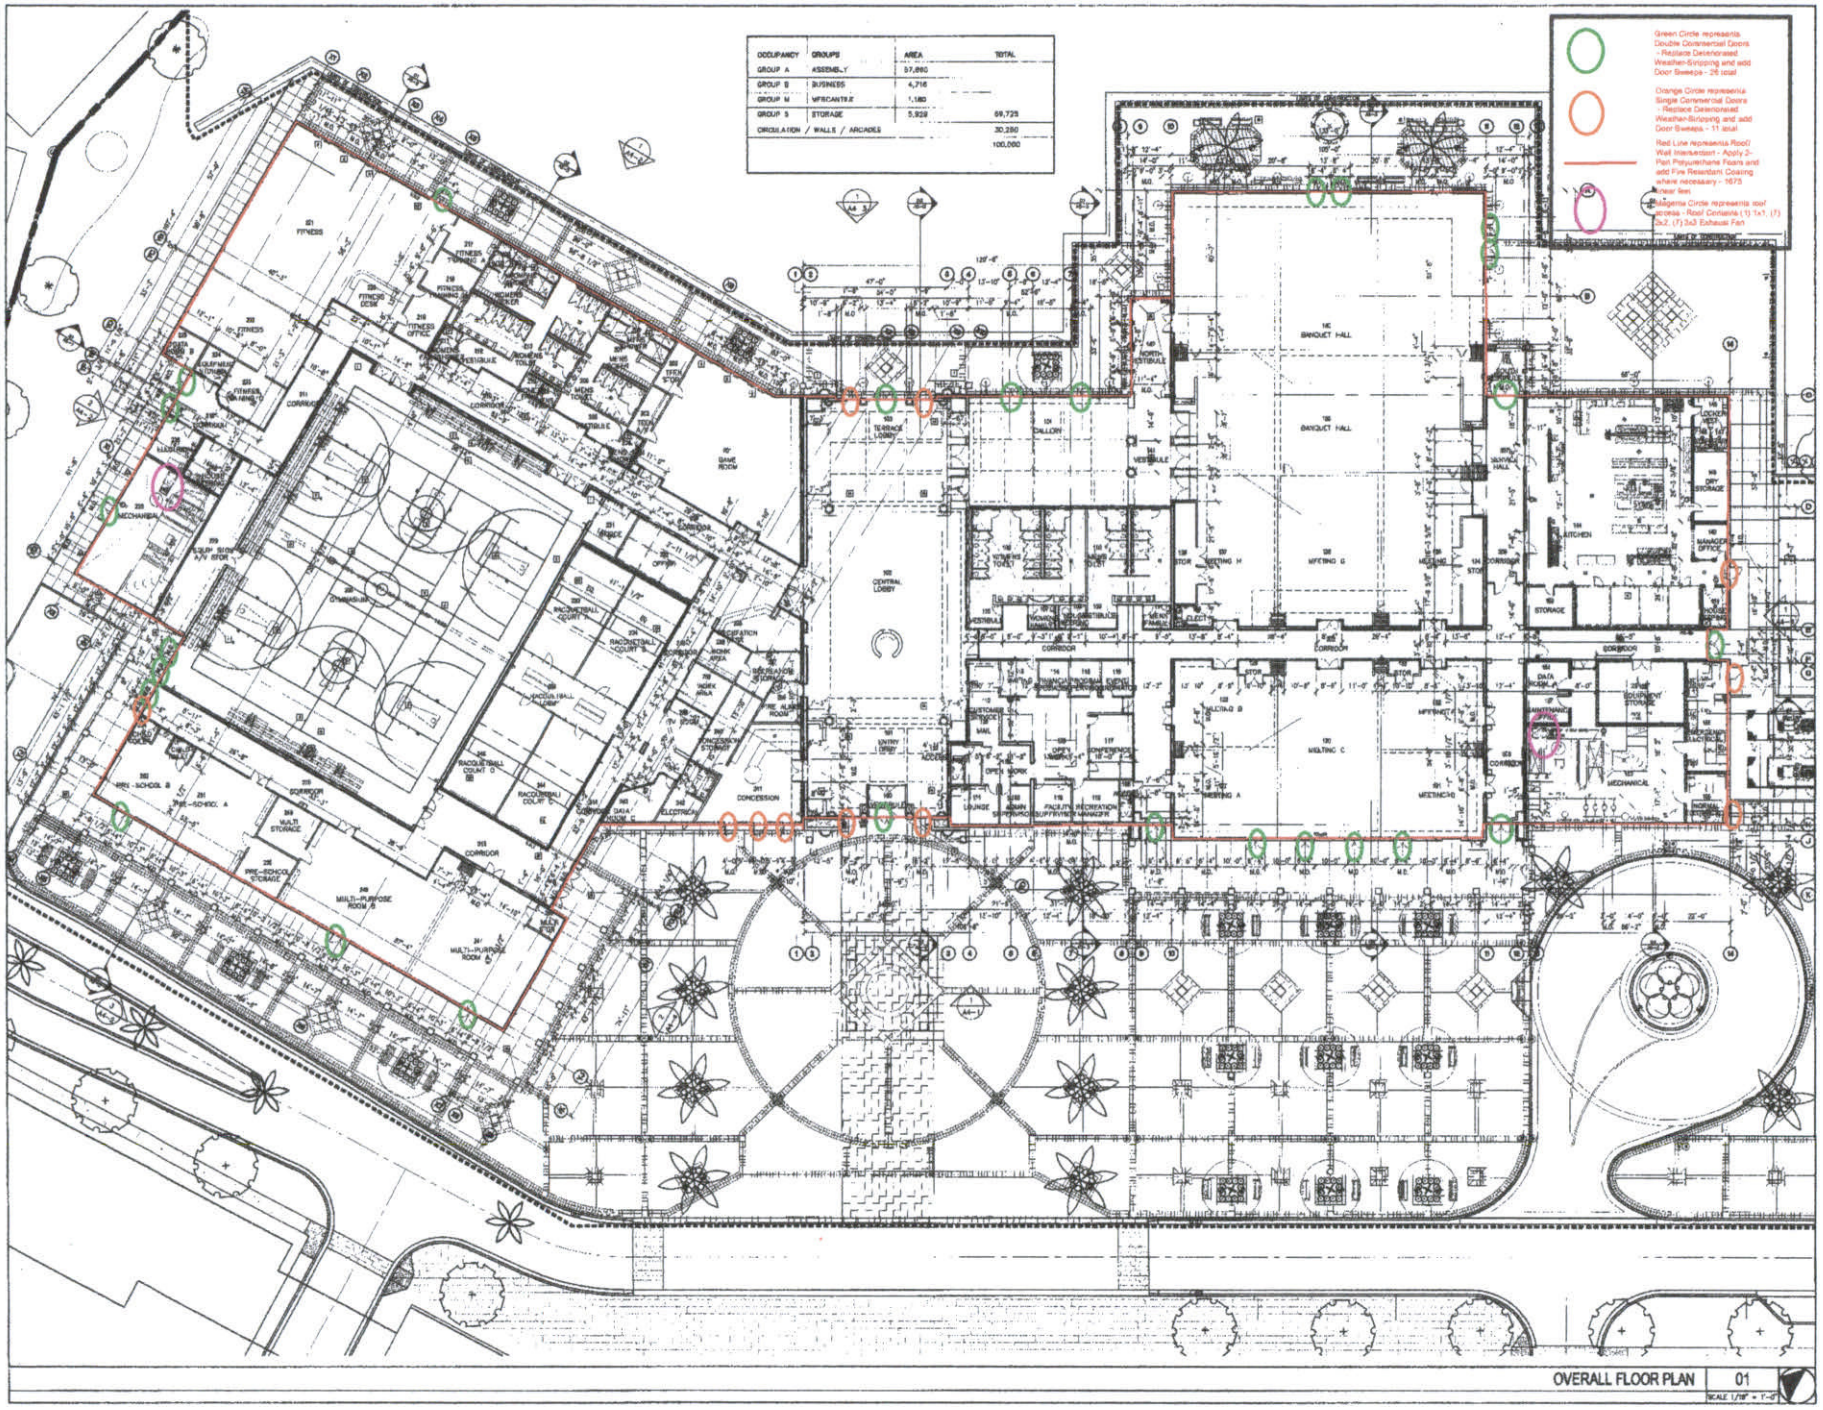

Song + Associates

SUFFOLK

CITY OF PORT ST. LUCIE

CIVIC CENTER

PORT ST. LUCIE FLORIDA

CONSTRUCTION DOCUMENTS

OVERALL FLOOR PLAN

A1-0